



Thalweg Cross Sections

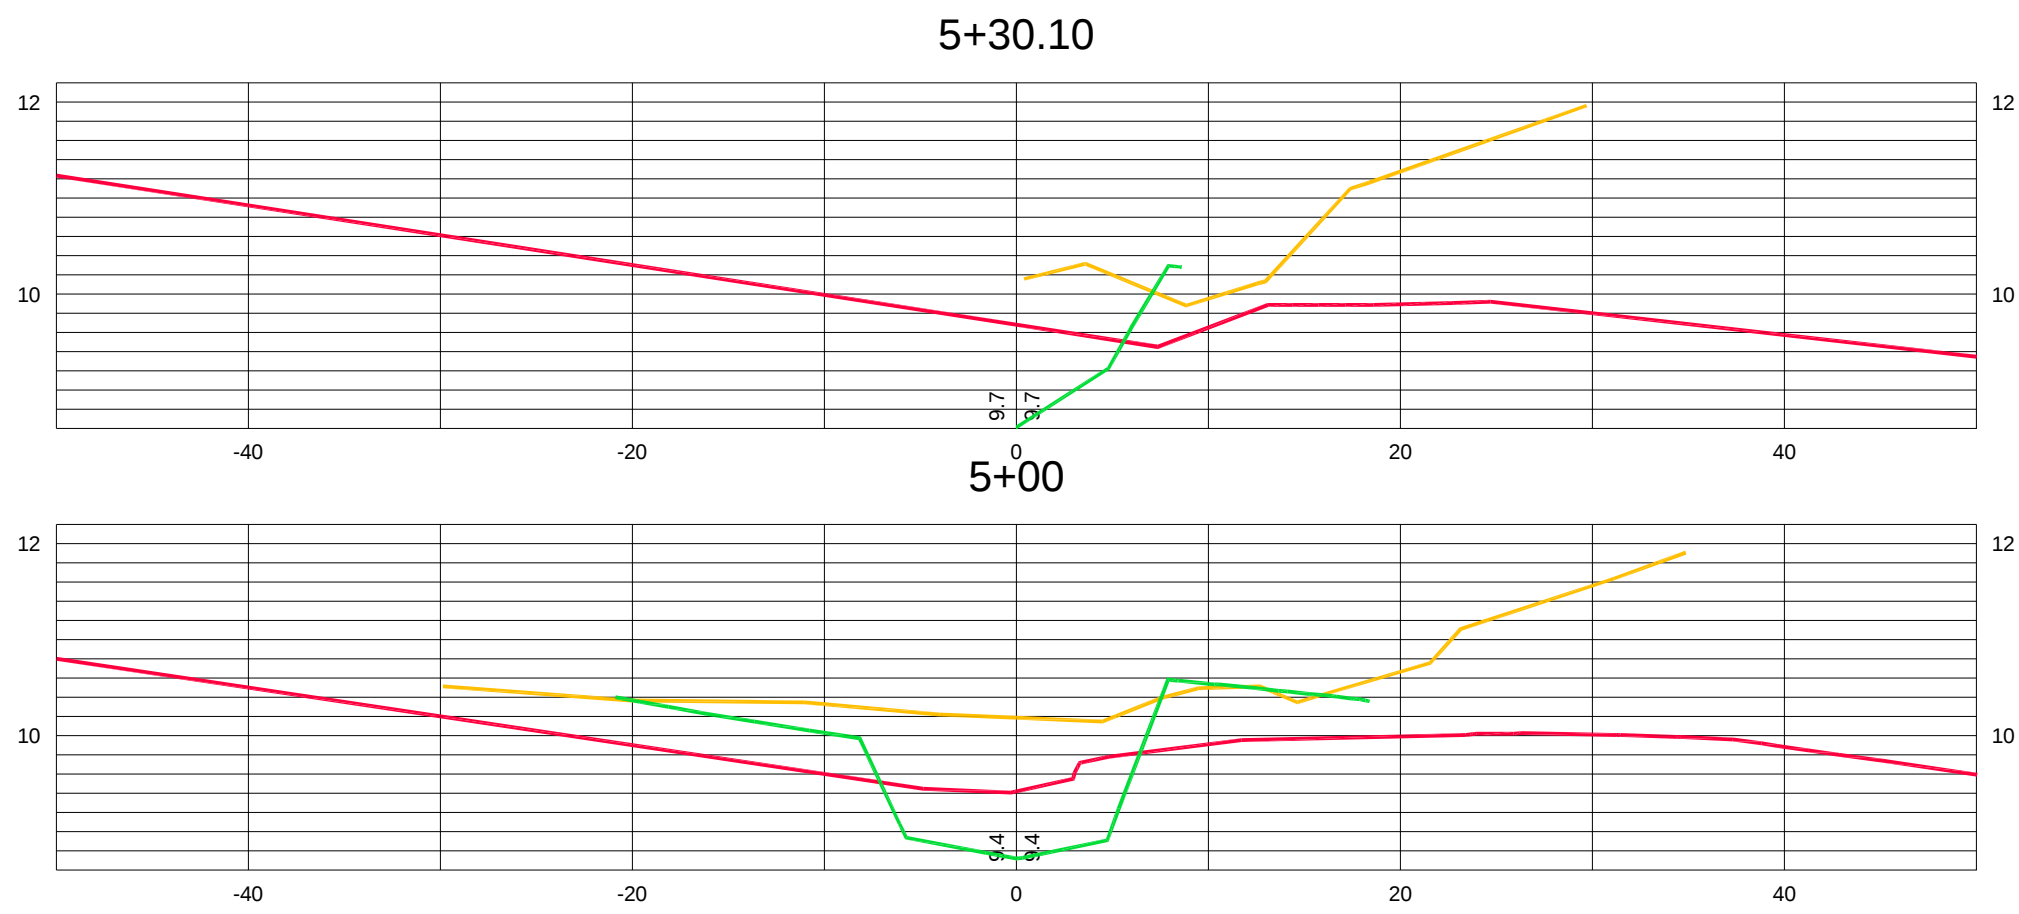


Berm Cross Sections

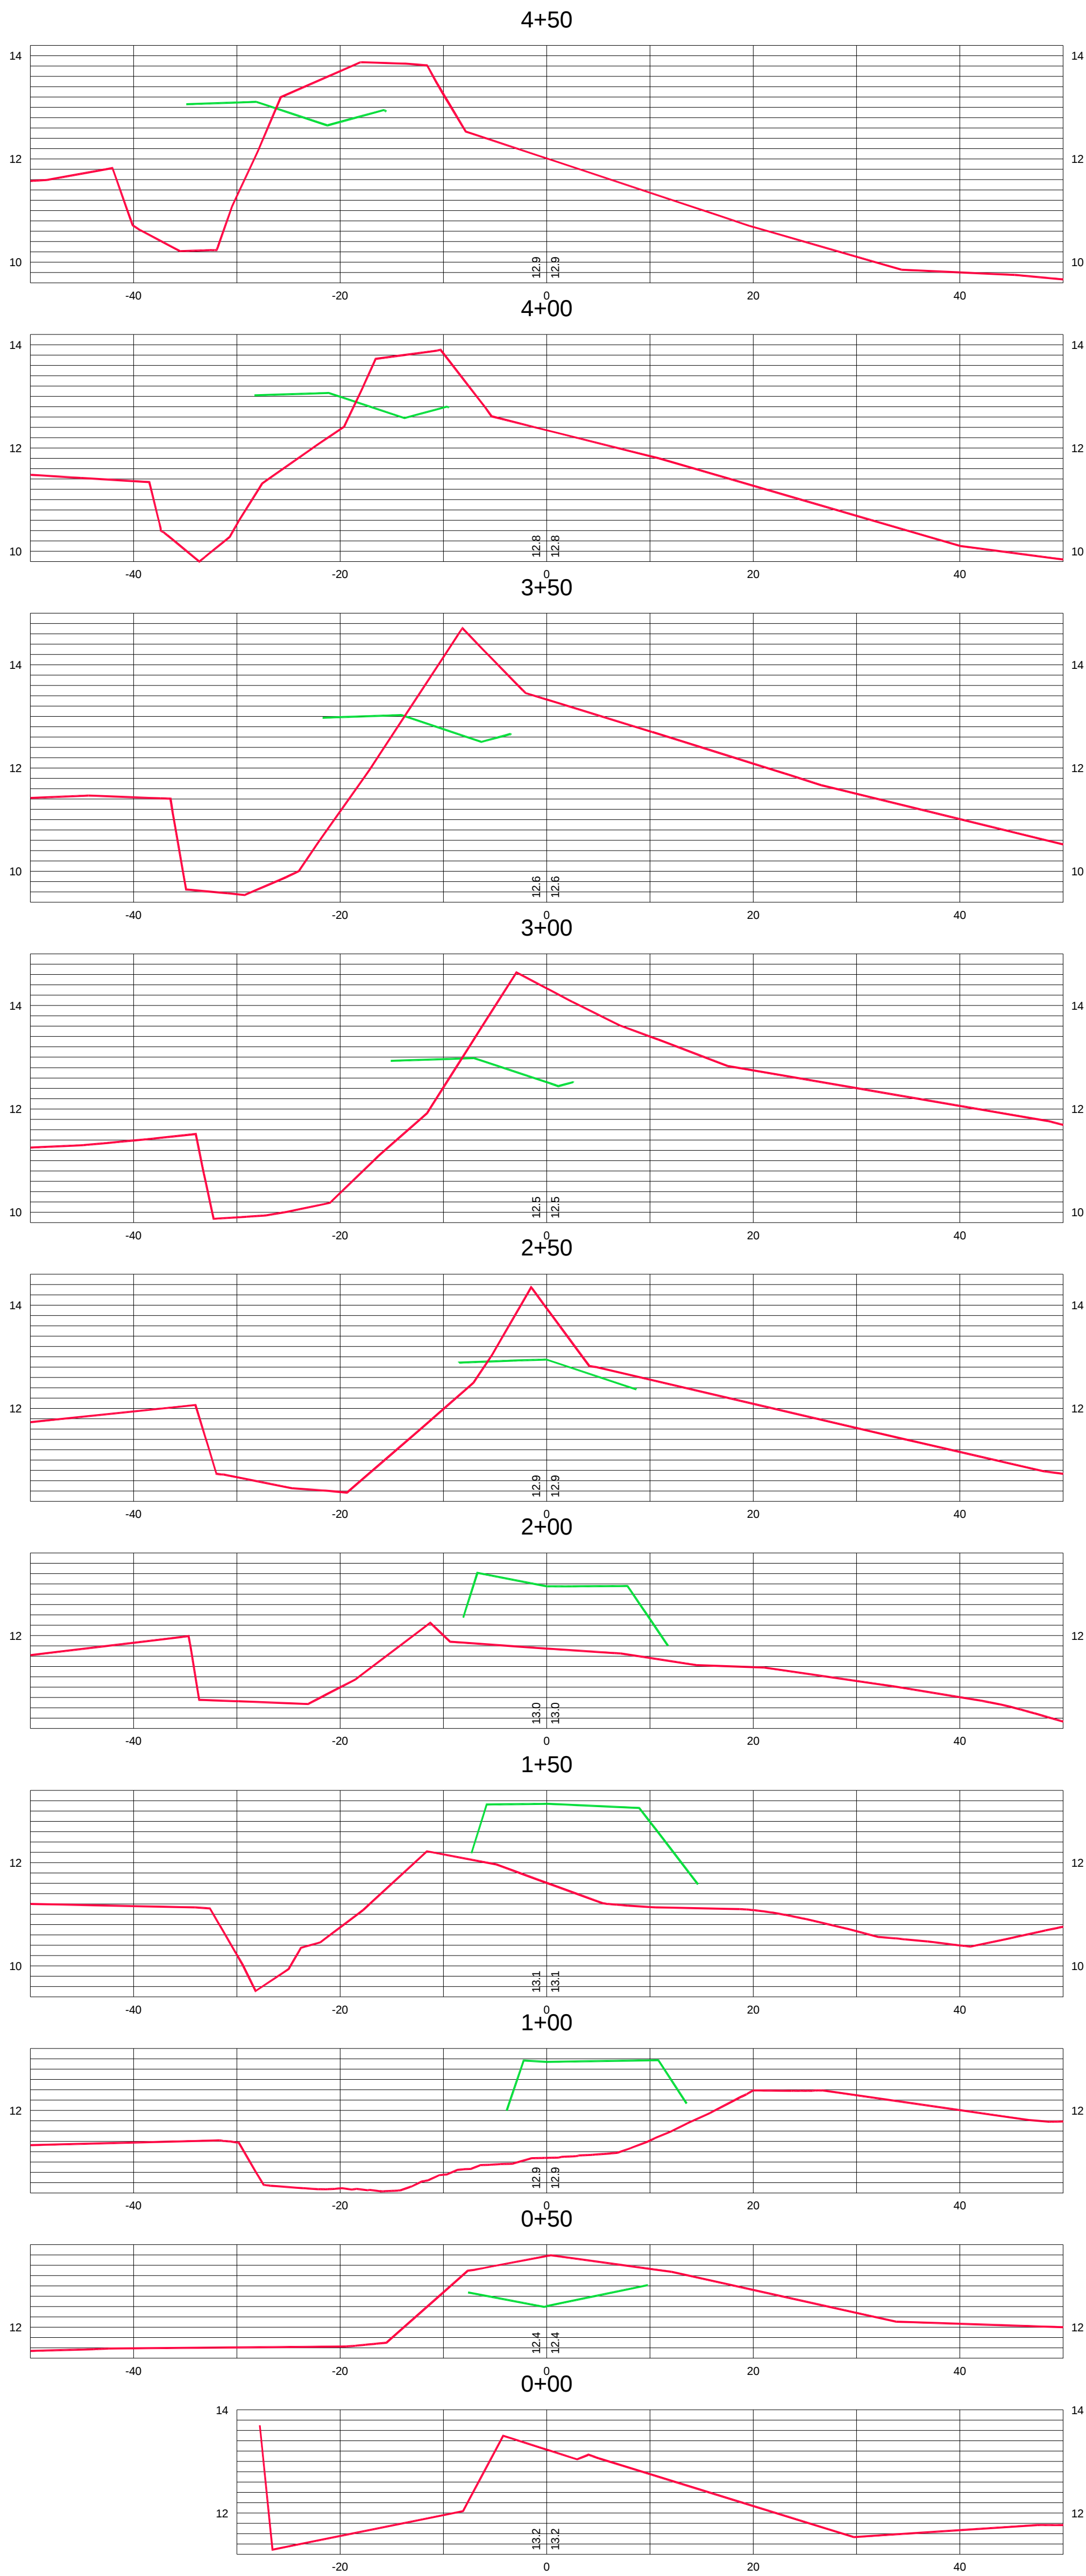

Original Topography (by Harmsen)
Interim Grade (9/6/2012)
As-Built Grade (10/11/2012)

Horizontal Scale: 1" = 10' Vertical Scale: 1" = 5'

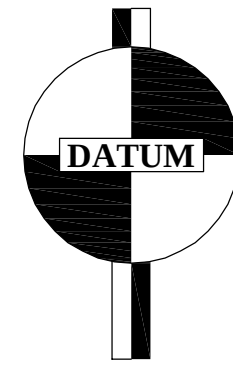

MLLW
Project Control Points 1 & 2


PROJECT MANAGER: Craig Powell

SIGNATURE:

Team4 Engineering
5823 NE Minder Road
Poulsbo, WA 98370
phone: 360 297-5560
fax: 360 297-7951



TITLE
**Livingston Bay Estuary Restoration
Post-Construction Cross Sections**
CLIENT
The Nature Conservancy

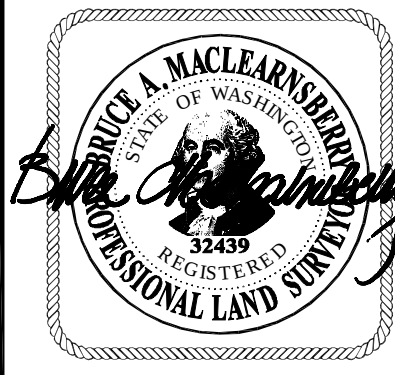

DATE SEALED 10/16/12

REV NO	REVISION DESCRIPTION	DATE	BY

SCALE: **AS NOTED**
DATE: **October 11, 2012**
DESIGN:
DRAWN: **BAM**
CHECKED: **BAM**
SEC 29 TWP 32 RNG 3 E
JOB No. 856

SHEET 3 OF 3